


LOCHGELLY
PUBLIC PARK

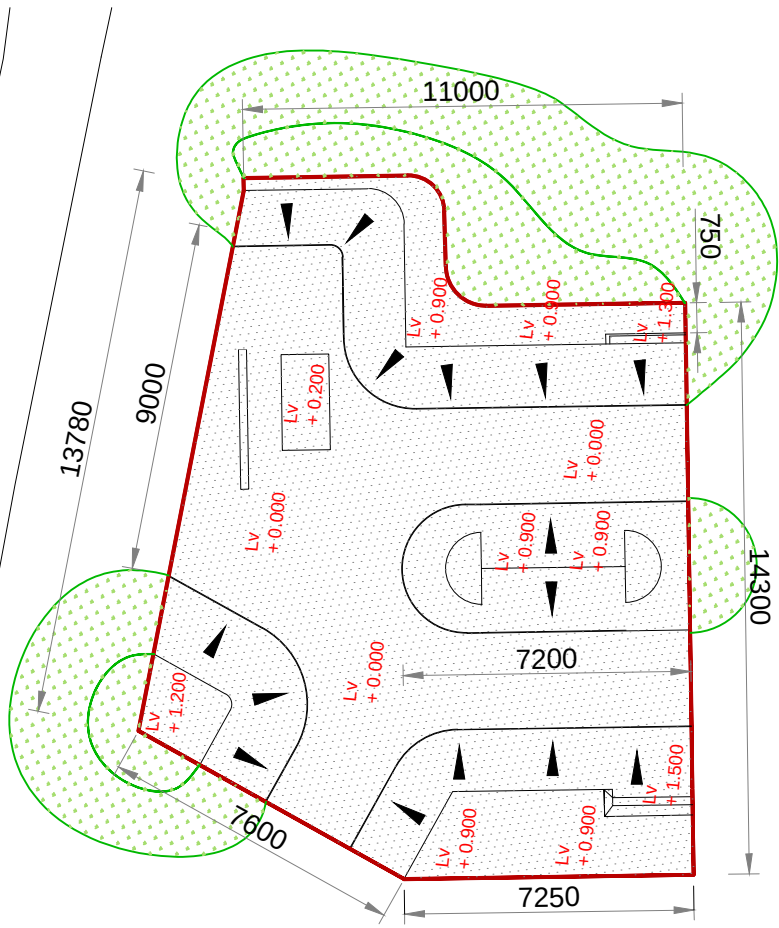

AS BUILT MUGA